

Nº 43274


1053

665

R.P.O. Vol. 116
C.T. Vol. 715

Fol. 333 ✓
Fol. 467

Ward of Chaguanoas
County of Caroni
Cadastral Sheet D.B.B

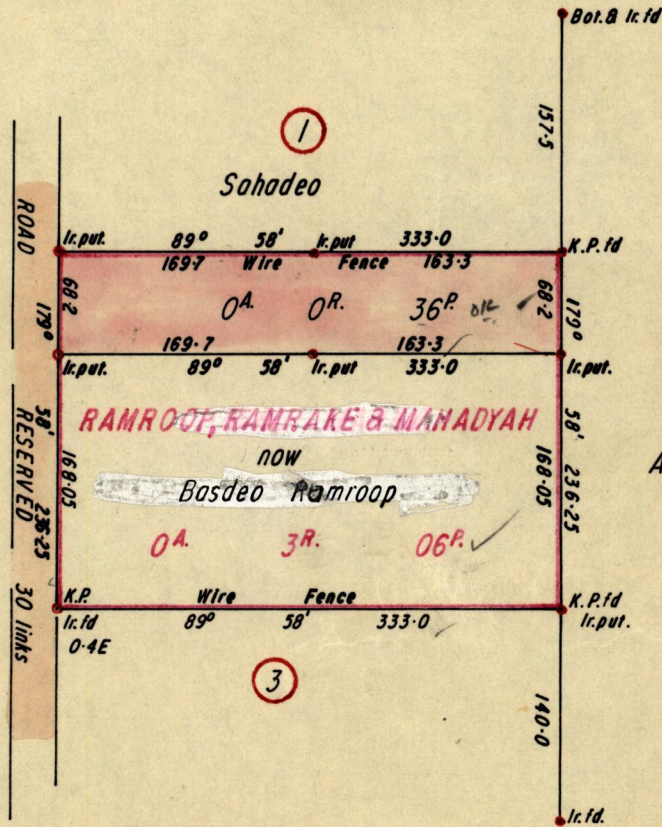

Approved

John Samuel

6.4.79.

Director of Surveys

SCALE 1:1000

Note: To obtain compass bearings ~~add~~^{add} ~~subtract~~ 2 minutes Distances are in links

PLAN of a Parcel of land coloured pink in the Ward of Chaguanoas

Containing thirtysix perches

Surveyed by me, with due authority, in December 1978

I certify that I have complied with rule 76 under Section 14 (2) (d) of the Land Surveyors' Ordinance 1952, and that this plan is correct.

Checked by *A. J. U. 30/3/79*

Land Surveyor, Trinidad

John Aguirre
13th March 1979

LANDS AND SURVEYS VAULT RECORDS

005

Original bk 723 fol. 28

Handwritten text, possibly a title or reference, appearing as a faint yellowish mark in the center of the page.

Small handwritten mark or signature in the lower right quadrant.

Small handwritten mark or signature at the bottom center.