

R.P.O. Vol. 442 Fol. 93

Ward of Savana Grande

C.T. Vol. 2461 Fol. 129

County of Victoria


U.P.R.N. No.:

Cadastral Sheet G.15.A 64E
1/a, 1/b

Vol. 5035 Fol. 109

Process ~~304~~ 80904

G.N.
Cassini

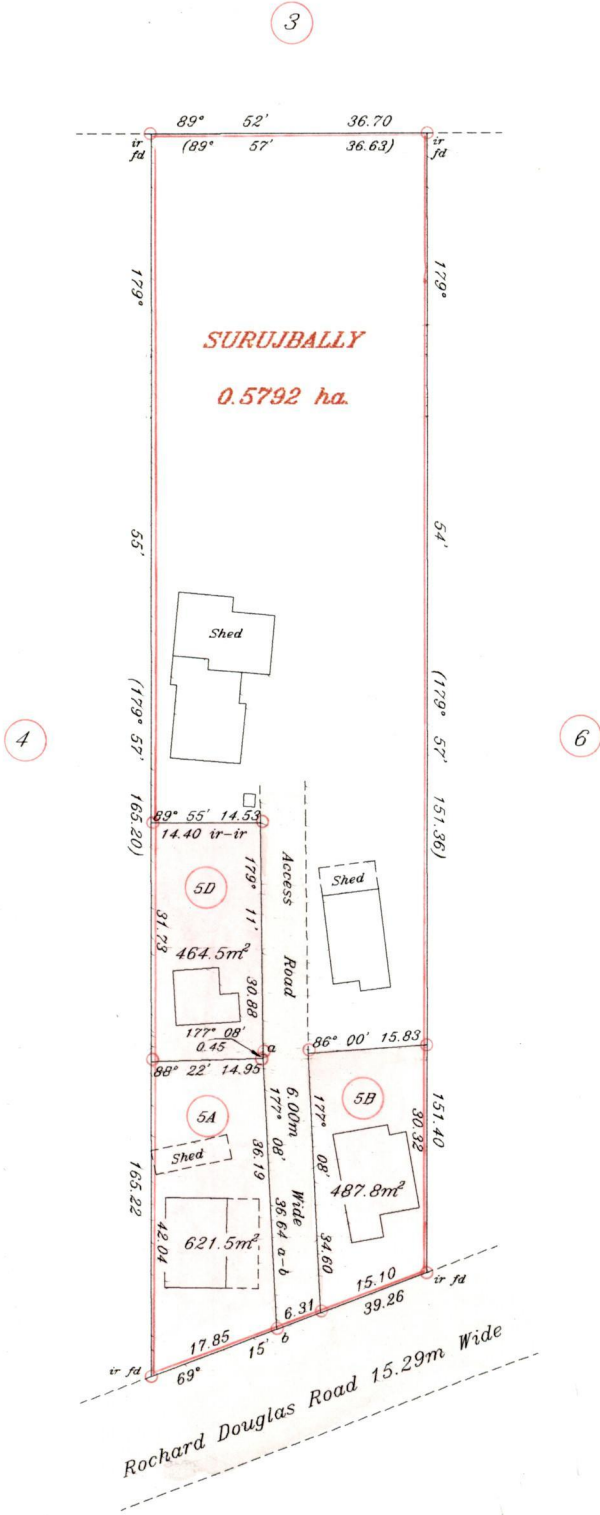

938167

Ramdeo, Gumati + Christine Surujbally

Reference: Bk. 988 Fol. 67

SCALE 1: 1000

Distances are in metres

○ Denotes iron put except otherwise stated

Approved


 Director of Surveys
 2001.06.11

Bearings are Cassini Grid based on Solar Observations

PLAN of 3 parcels of land coloured pink in the Ward of Savana Grande
 Containing together one thousand and five hundred and seventy three point eight square metres
 Surveyed by me, with due authority, in June 1999

In accordance with Rule 25(1) of the Land Surveyors' Regulations 1998, I certify that this plan is correct.

Checked by ~~SH.01.06.04~~
 Entered
 L.A. Roopchand
 Trinidad & Tobago Land Surveyor 27/11/2000

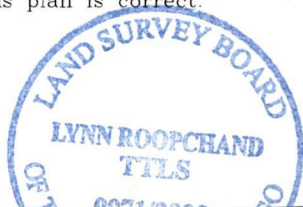

03
1771
Original BK. 387 fol. 311

5A - Vol. 5035 Fol. 125 Ramdeo, Gumati + Christine Surujbally.

5B - Vol. 5035 Fol. 159 Ramkarran Surujbally, Ramdaye Ramkarran.

5D - Vol. 5035 Fol. 143 Leetadeo, Lisa + Sacha Surujbally.

5 DEC 2000
Lands and
Surveys
Division