1236

1

L. & S.—54

№ 8543

See Bk. 232 Fol. 117
R.P.O. Vol. 194 *Fol.* 513
C.T. Vol. *Fol.*

Ward of Chaguanas
County of Caroni
Cadastral Sheet 34E/2/c (D.9.N)

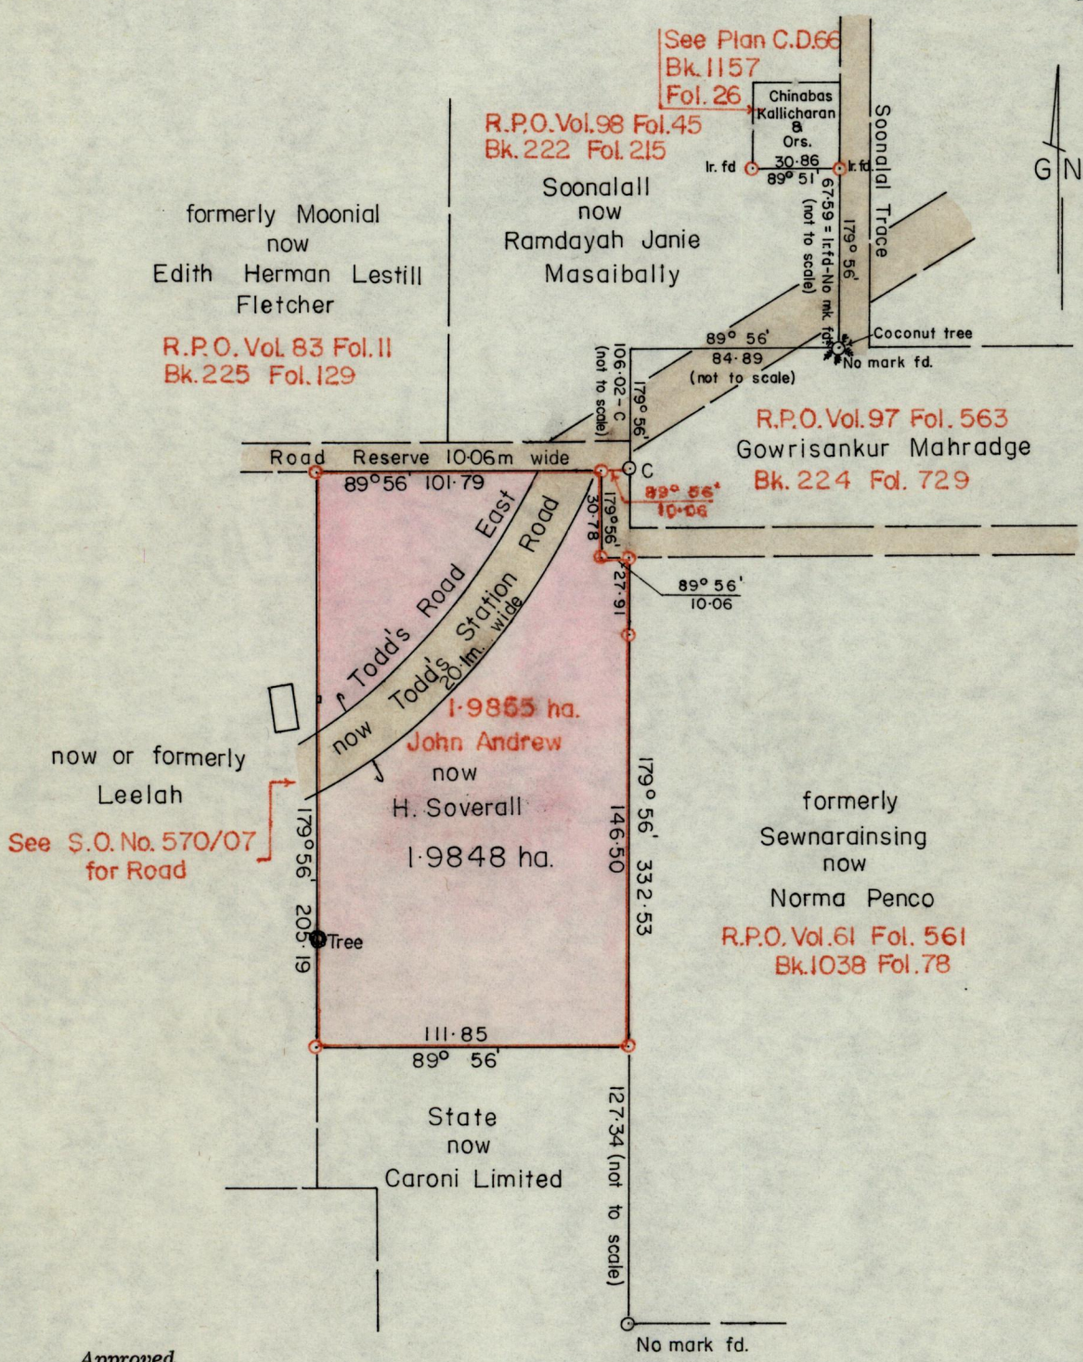

Approved

.....
Director of Surveys

Original Survey 232 : 117

⊙ Denotes Iron put unless otherwise stated.

SCALE 1 : 2500

Note: To obtain compass bearings add/~~subtract~~ 4 *minutes*

Distances are in METRES

PLAN of a Parcel of land coloured pink *in the Ward of* Chaguanas

Containing one point nine eight four eight hectares

Redefined ~~*Surveyed*~~ *by me, with due authority, in* January 1987.

I certify that I have complied with rule 76 under section 14(2)(d) of the Land Surveyors' Ordinance 1952, and that this plan is correct.

Checked by ..... Paul Williams

Entered ..... *Land Surveyor, Trinidad* 3/2/ 19 87

G.P., Tr./To.—2377—10,000—10/80