E. Wyke. 29/12/76 #29

957

L. & S.—54 441

№ 36171

R.P.O. Vol. 124 *Fol.* 65
C.T. Vol. 2154 *Fol.* 89

Ward of Siparia
County of St. Patrick
Cadastral Sheet G18F

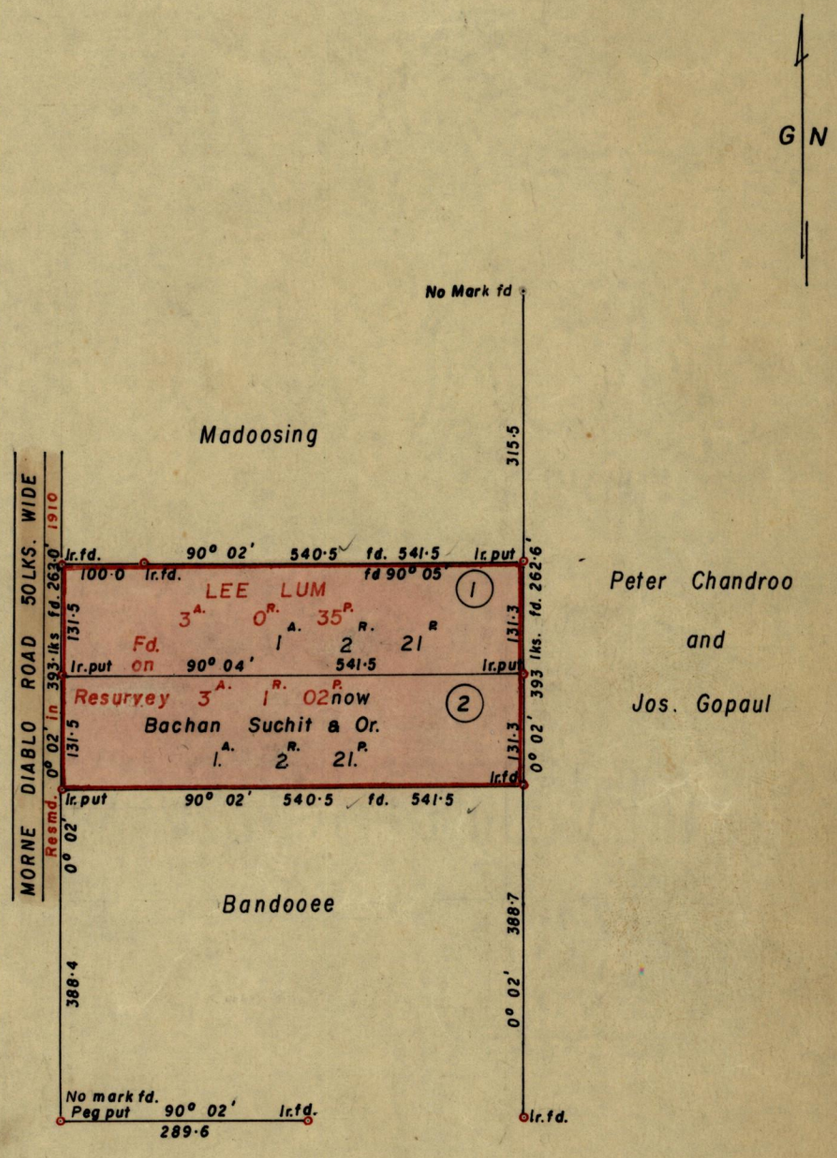

Approved
6.1.78. *Director of Surveys*

SCALE 1:2500

Note: To obtain compass bearings ~~add~~/~~substract~~ 2 *minutes* *Distances are in* Feet

PLAN of 2 *Parcels of land coloured* pink *in the Ward of* Siparia

Containing Together Three acres one rood and two perches

Surveyed by me, with due authority, in September 1976

I certify that I have complied with rule 76 *under Section* 14 (2) (*d*) *of the Land Surveyors' Ordinance* 1952, *and that this plan is correct.*

Checked by 30/12/76

Entered

Land Surveyor, Trinidad 1st Oct 19 76

G.P., Tr./To.—616—15,000—8/74

LANDS AND SURVEYS VAULT RECORDS